




CHECK SET. OCT 2. 2013





CHECKSET · OCT 2 · 2018



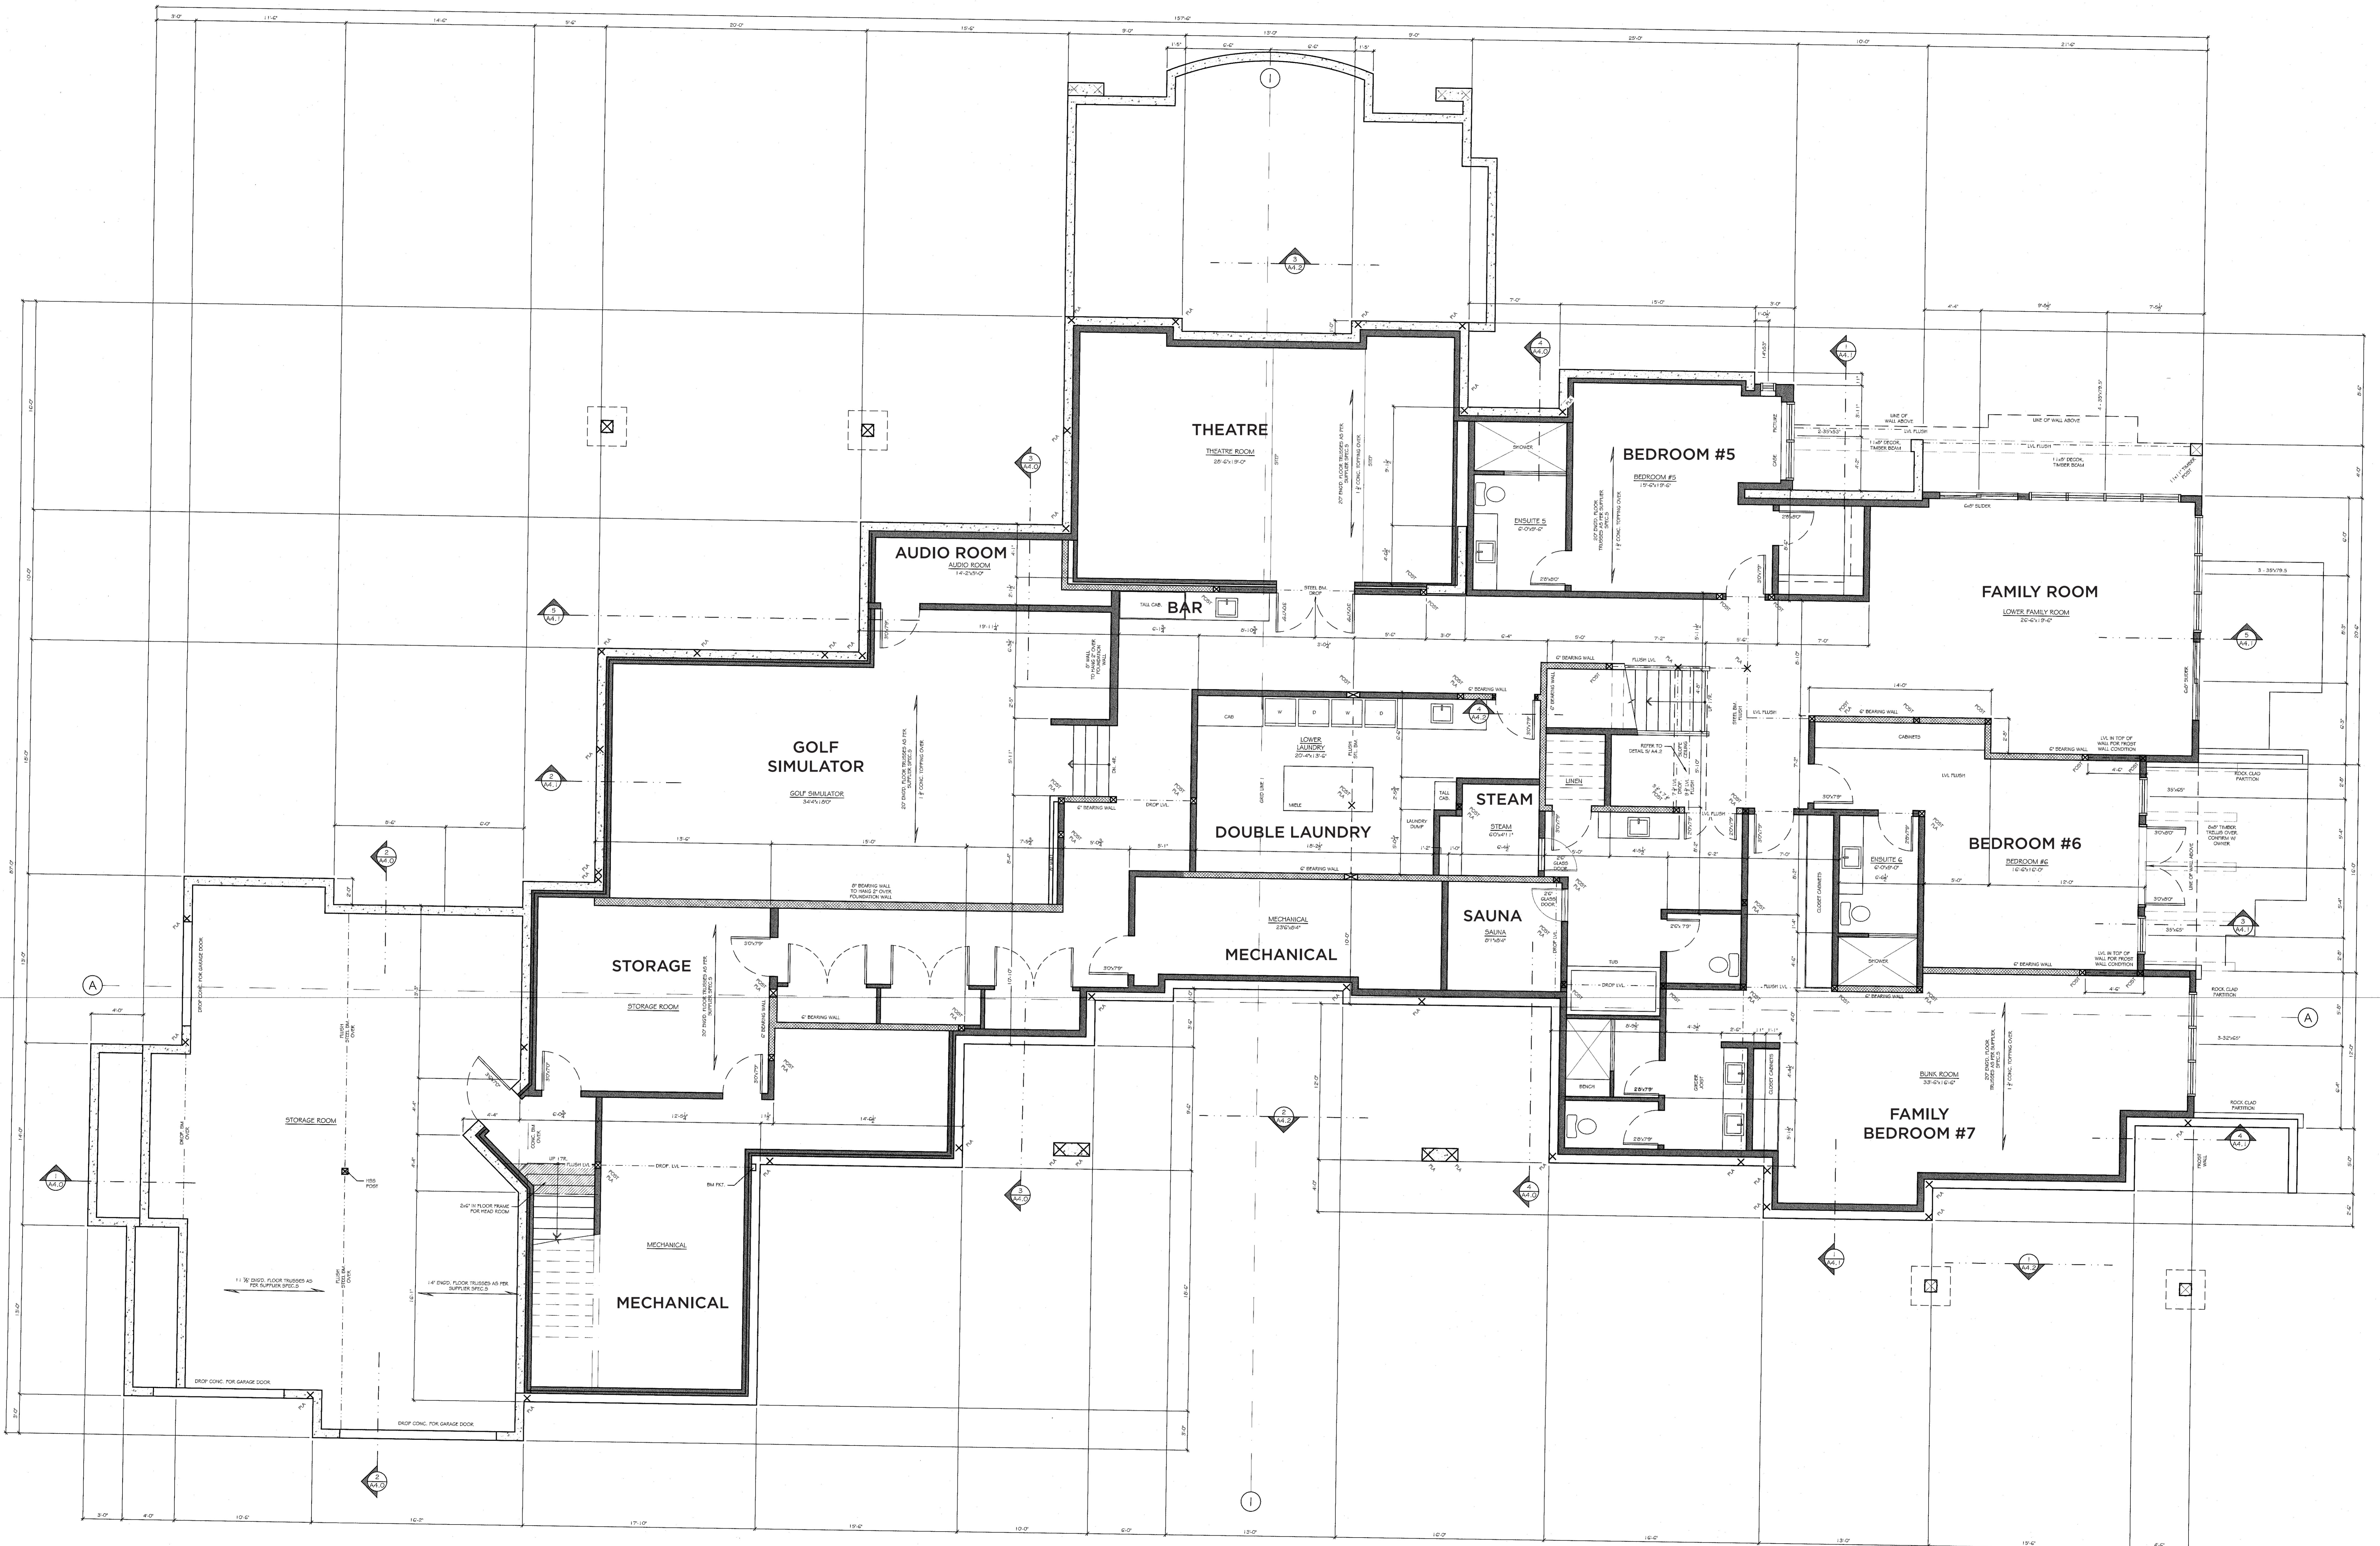

LOWER FLOOR PLAN

4846 R.F. + 2489 B.F. STORAGE/MECH.
 TO ALL WINDOWS @ 7'-0" ABOVE FIN. UNLESS OTHERWISE NOTED
 ALL INTERIOR WALLS ARE 2'-0" UNLESS OTHERWISE NOTED

NOTES

- DO NOT SCALE DRAWING.
- VERIFY ALL DIMENSIONS AND INFORMATION.
- REPORT ERRORS OR DISCREPANCIES TO THE DESIGNER.
- ALL WORK TO CONFORM TO THE APPLICABLE BUILDING CODE.

PROJECT:
 COLBORNE RESIDENCE

ADDRESS AND LEGAL:
 12407 COLDSTREAM CREEK ROAD,
 COLDSTREAM, B.C.

LOT: 13
PLAN: 178, sec 14 #15, TP 9, ODYD EXCEPT
 PLAN B6806, AND ADJOINING LANDS

DRAWING TITLE:
 LOWER FLOOR PLAN

DATE: 2018.09.30
SCALE: AS NOTED
DRAWN BY: LOREN HARMS

check set - oct 2, 2018


LIVING DESIGNS
 PH. : 403-678-5520

NO.	REVISION	DATE
10.	AS-BUILTS	2018.09.30
9.	FLOOR PLAN REVISIONS	2018.02.19
8.	GARAGE REVISIONS	2017.07.21

REVISION:
 10

SHEET NO.:

A2.1

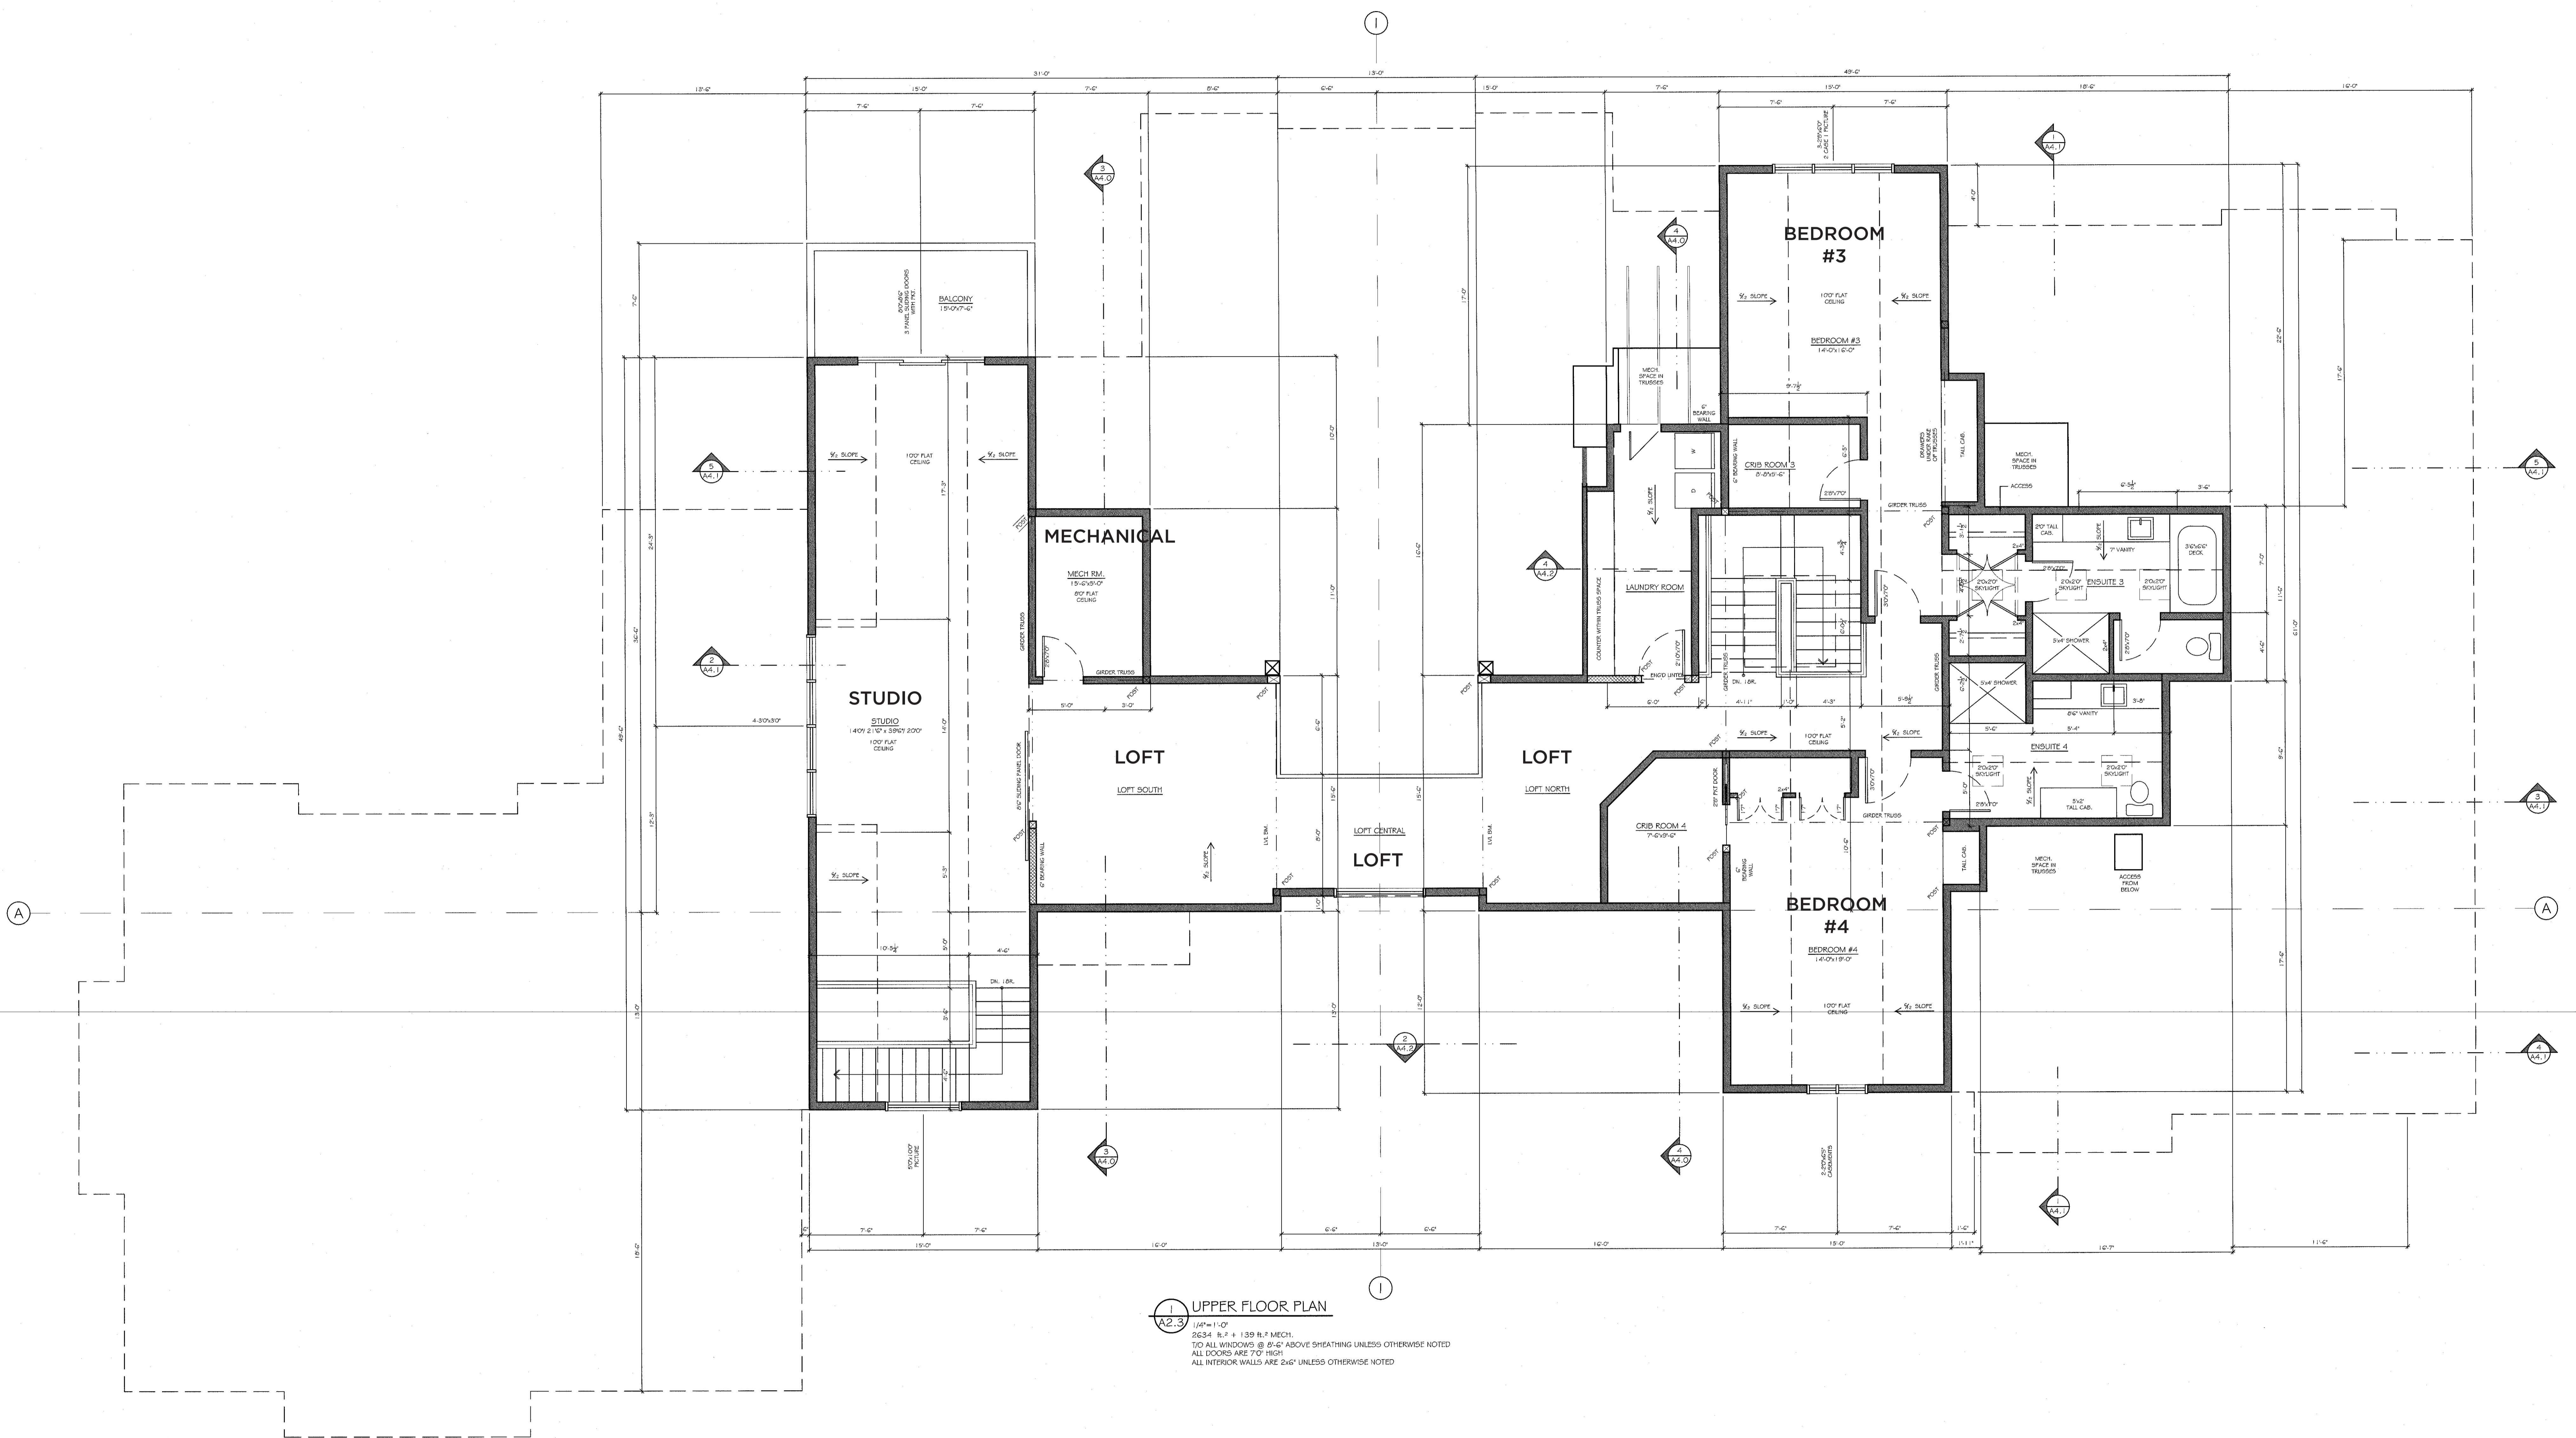

1 UPPER FLOOR PLAN
 2634 R.F. + 139 R.F. MECH.
 TO ALL WINDOWS @ 6'-0" ABOVE SHEATHING UNLESS OTHERWISE NOTED
 ALL DOORS ARE 7'-0" HIGH

CHECK SET - OUT 2 - 2018

LIVING DESIGNS
 PH: 403-678-5520

NOTES
 -DO NOT SCALE DRAWING.
 -VERIFY ALL DIMENSIONS AND INFORMATION.
 -REPORT ERRORS OR DISCREPANCIES TO THE DESIGNER.
 -ALL WORK TO CONFORM TO THE APPLICABLE BUILDING CODE.

PROJECT:
COLBORNE RESIDENCE

ADDRESS AND LEGAL:
 12407 GOLDSTREAM CREEK ROAD,
 COLDSTREAM, B.C.


LOT: 13
 PLAN: 178, sec 14 #15, TP 9, ODDY EXCEPT
 PLAN B6806, AND ADJOINING LANDS

DRAWING TITLE:
 UPPER FLOOR PLAN

DATE: 2018.09.30
 SCALE: AS NOTED
 DRAWN BY: LOREN HARMS

NO.	REVISION	DATE
10.	AS-BUILTS	2018.09.30
9.	FLOOR PLAN REVISIONS	2018.02.19
8.	GARAGE REVISIONS	2017.07.21

REVISION:
 10
 SHEET NO.:
 A2.3

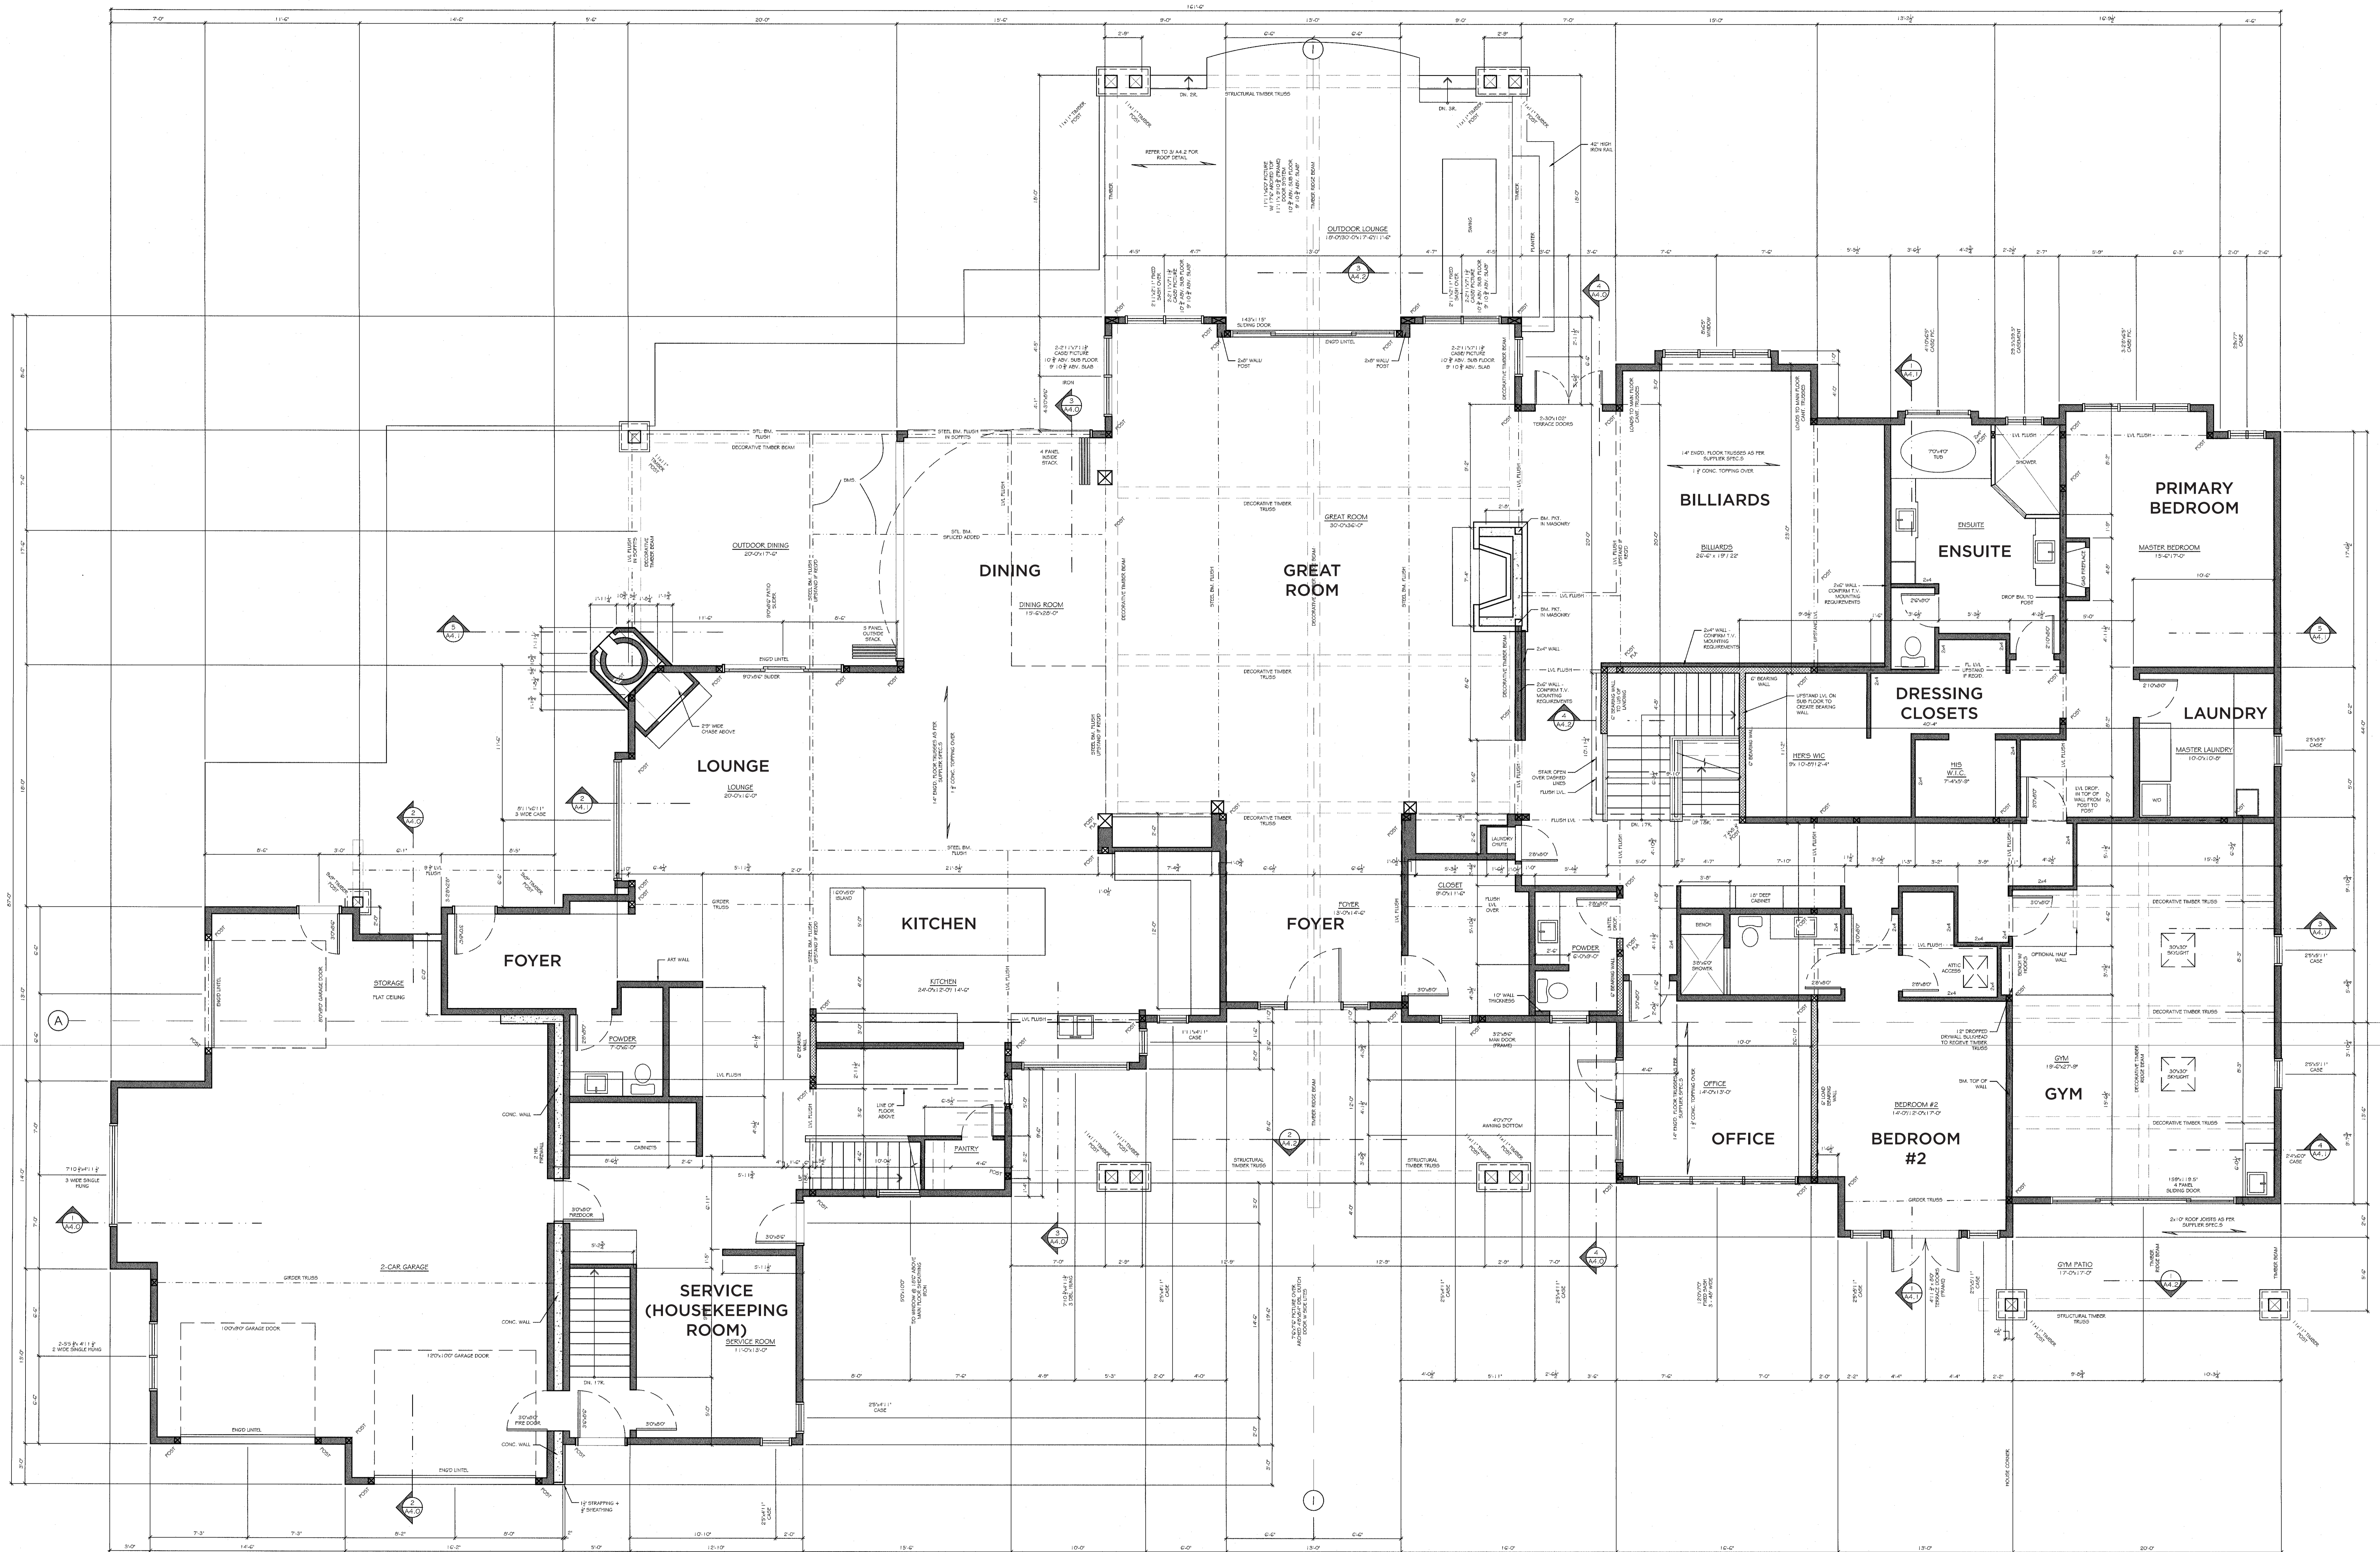

A2.2 MAIN FLOOR PLAN
 1/8" = 1'-0"
 6555 R.F. + 1222 R.F. GARAGE + 200 R.F. CANTY.
 10' ALL WINDOWS @ 6'-0" ABOVE SHEATHING UNLESS OTHERWISE NOTED
 ALL INTERIOR WALLS ARE 5/8" UNLESS OTHERWISE NOTED

CHECK SET OCT 2 2018

LIVING DESIGNS
 PH. 1 403-678-5520

NOTES
 -DO NOT SCALE DRAWING.
 -VERIFY ALL DIMENSIONS AND INFORMATION.
 -REPORT ERRORS OR DISCREPANCIES TO THE DESIGNER.
 -ALL WORK TO CONFORM TO THE APPLICABLE BUILDING CODE.

PROJECT:
 COLBORNE RESIDENCE

ADDRESS AND LEGAL:
 12407 COLDSTREAM CREEK ROAD,
 COLDSTREAM, B.C.

LOT: 13
PLAN: 178, sec 14 415, TP 9, ODYD EXCEPT
 PLAN B6806, AND ADJOINING LANDS

DRAWING TITLE:
 MAIN FLOOR PLAN

DATE: 2018.09.30
SCALE: AS NOTED
DRAWN BY: LOREN HARMS

NO.	REVISION	DATE
10.	AS-BUILTS	2018.09.30
9.	FLOOR PLAN REVISIONS	2018.02.19
8.	GARAGE REVISIONS	2017.07.21

REVISION:
 10
SHEET NO.:
 A2.2